


100
0 10
Millimetres
DO NOT SCALE

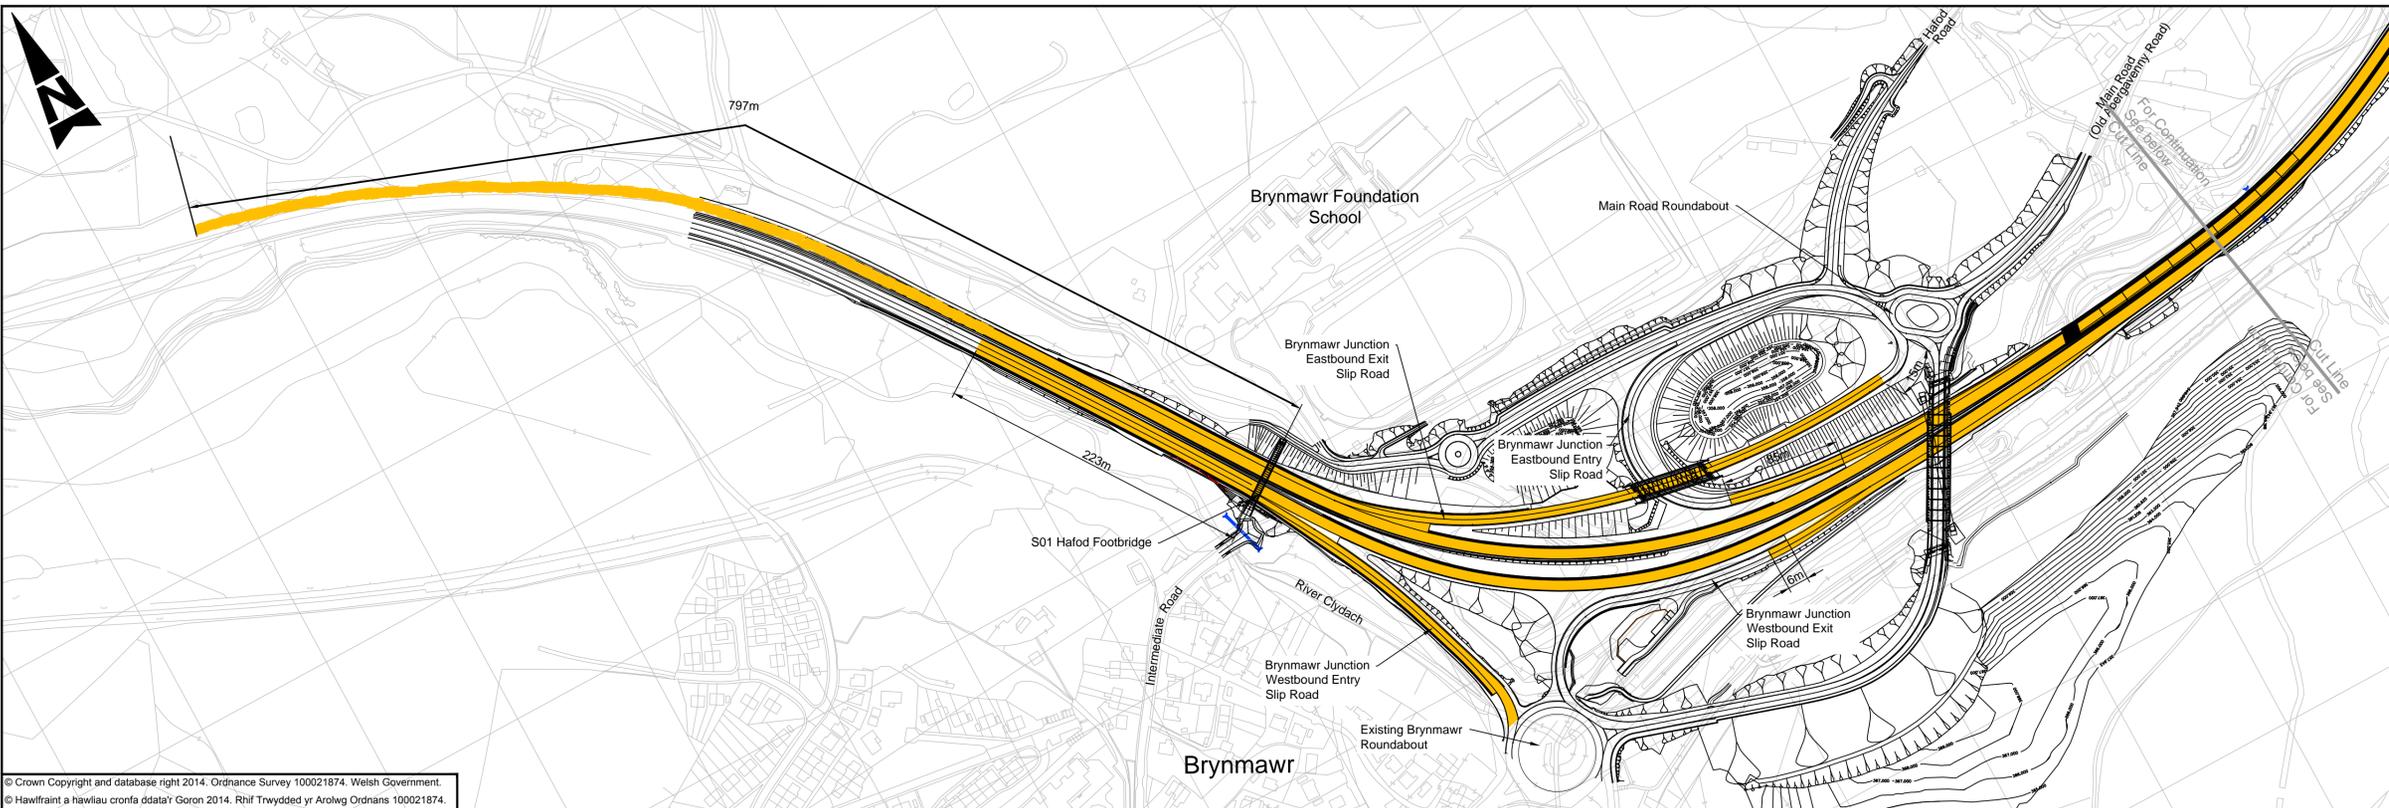


© Crown Copyright and database right 2014. Ordnance Survey 100021874. Welsh Government.
© Hawlfraint a hawliau cronfa ddata'y Goron 2014. Rhif Trwydded yr Arolwg Ordnans 100021874.


NOTES:
1. To be read in conjunction with Document No. A465HOV2-CH2-HAC-01_ML-DO-D-0025.

LEGEND:
50 mph speed limit extents


PLAN
Scale 1:2500

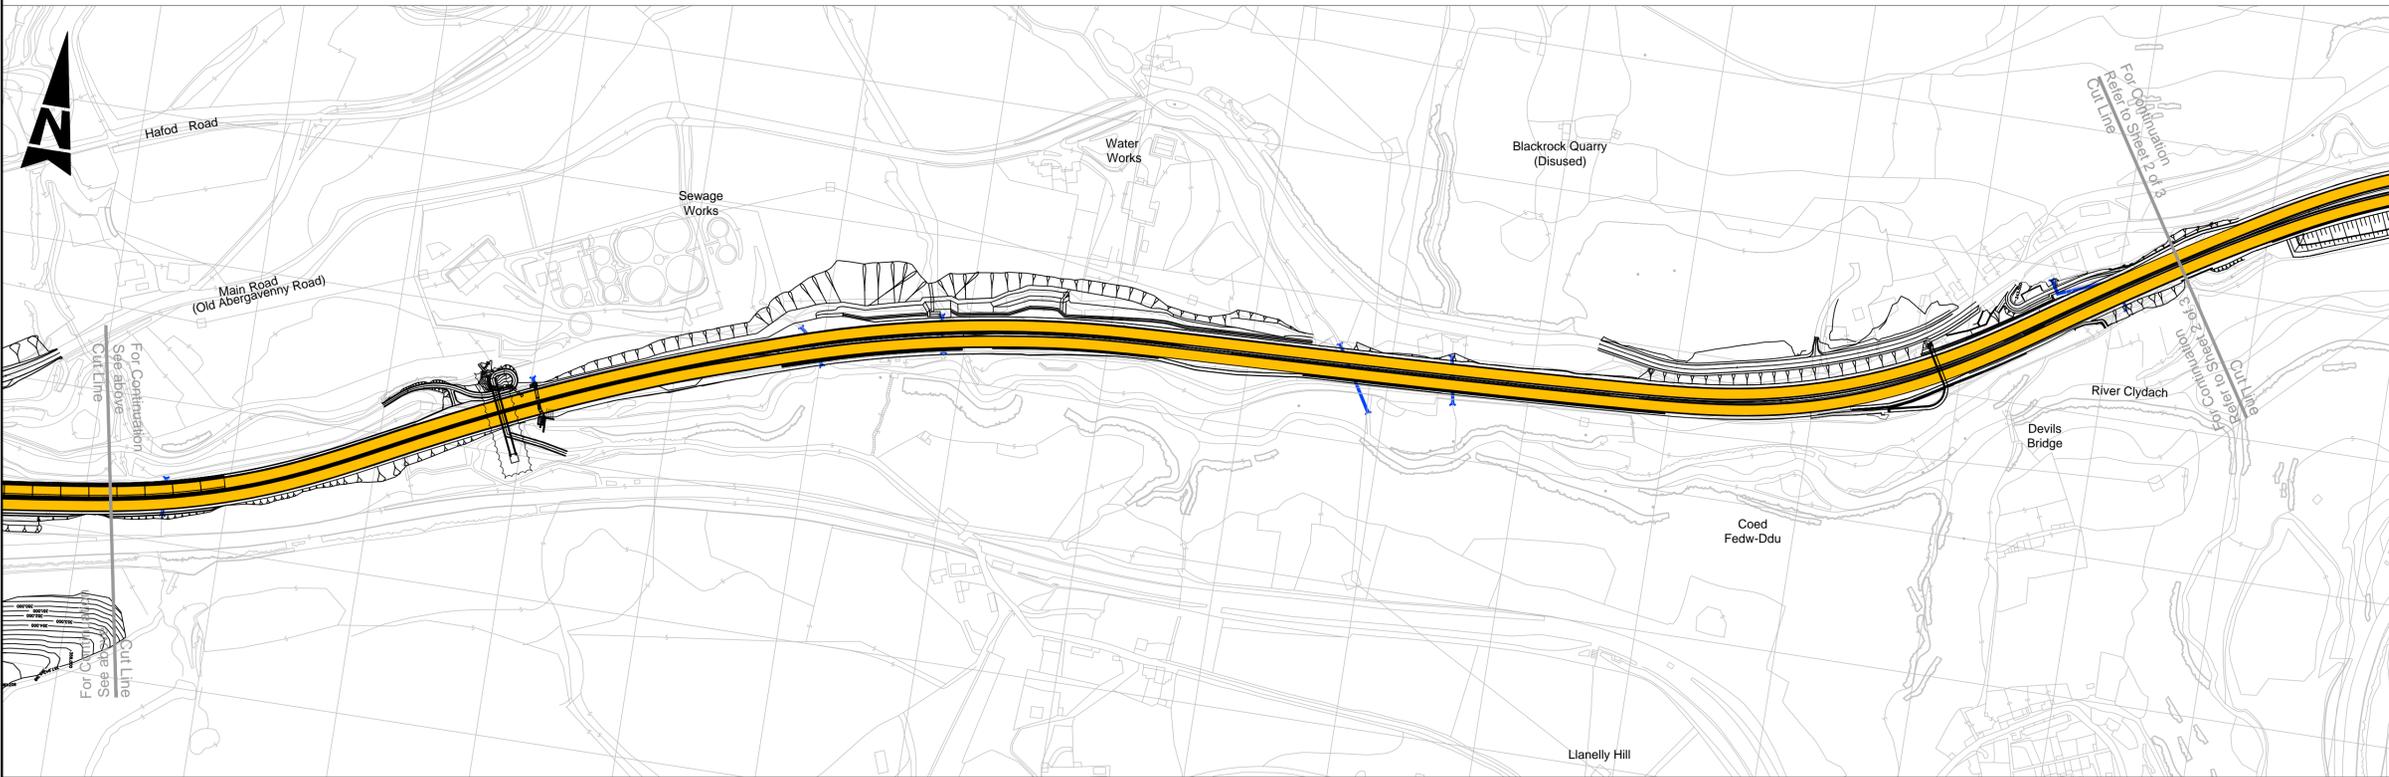

PLAN
Scale 1:2500

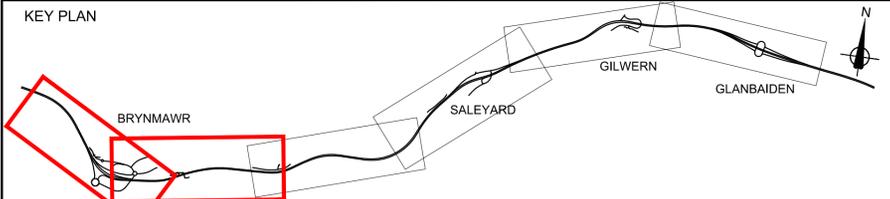

Rev	Description	By	Date	Chk'd	App
	Mark up: Amended extent of 50mph	WW	07/06/21		
P01	For information	LG	23/05/19	HA	SR

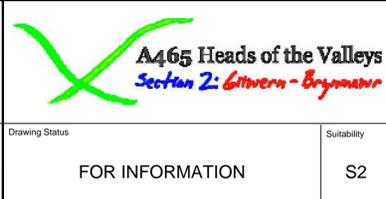

Drawing Title: PERMANENT TRAFFIC RESTRICTIONS IMPOSITION OF 50MPH SPEED LIMIT SHEET 1 OF 3					
Scale	1:2500	Designed / Drawn	Checked	Approved	Authorised
Original Size	A1	Date	Date	Date	Date
Drawing number	A465HOV2-CH2-HAC-01_ML-DR-D-0001				Revision
Suitability	S2				Mark up

Plotted: May 24, 2019 - 3:01pm by: ALBERTO H