



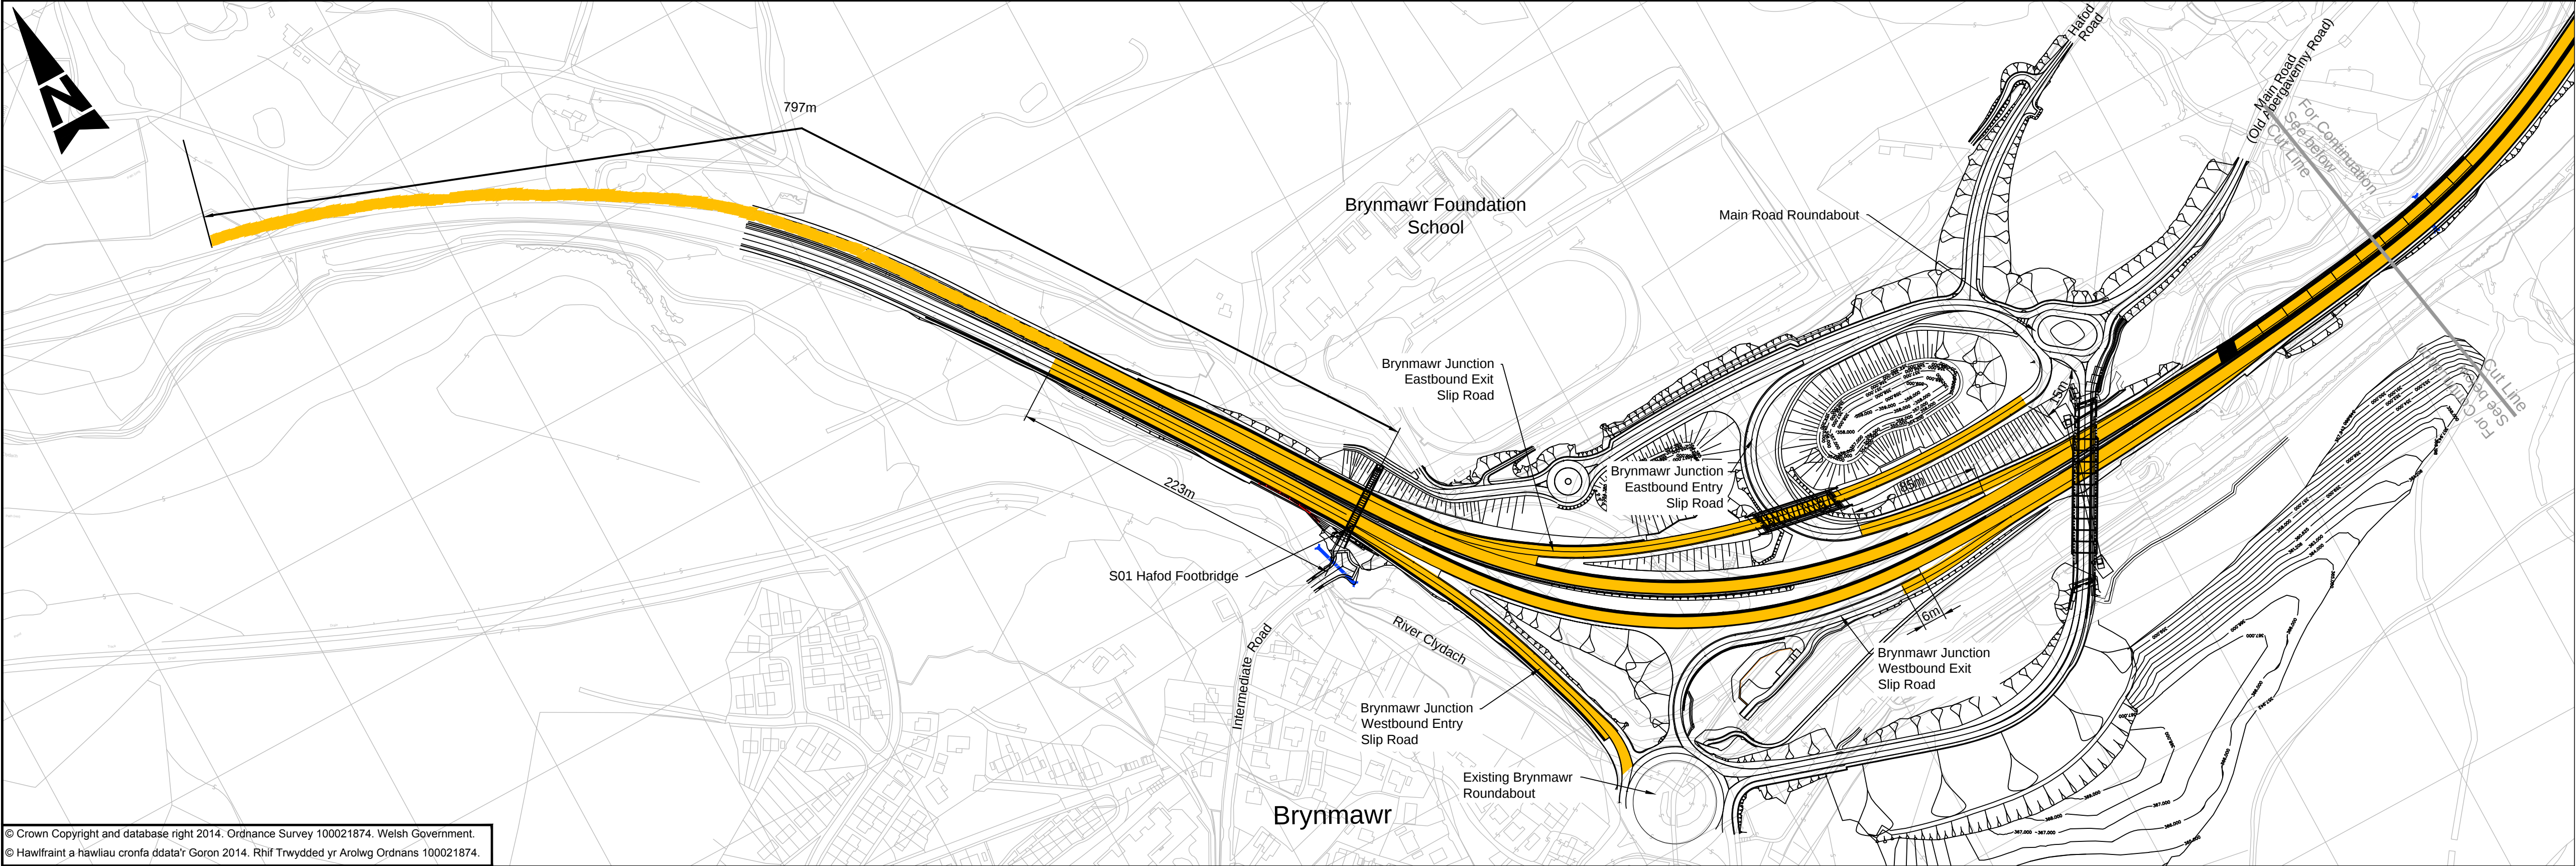


© Crown Copyright and database right 2014. Ordnance Survey 100021874. Welsh Government.
© Hawlfraint a hawliau cronfa ddata'r Goron 2014. Rhif Trwydded yr Arolwg Ordians 100021874.

PLAN
Scale 1:2500

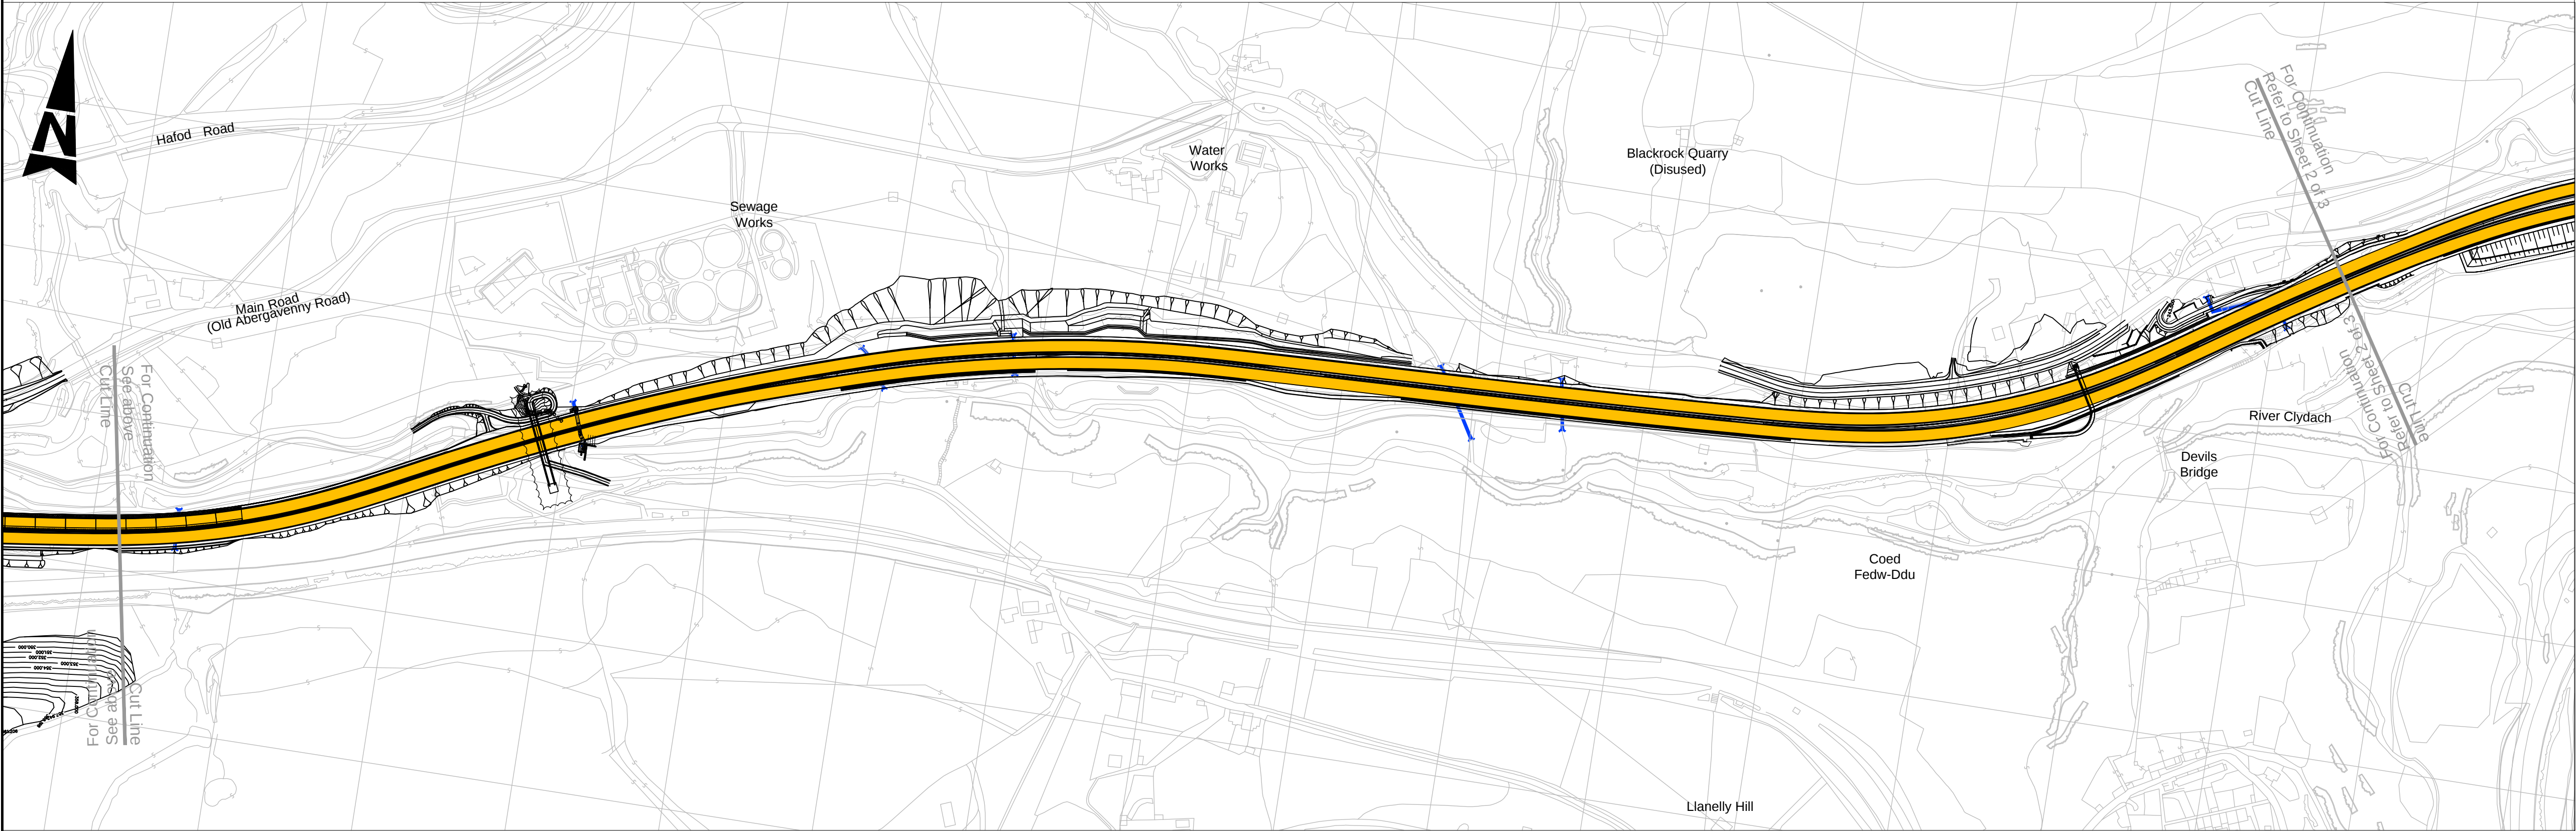

PLAN
Scale 1:2500

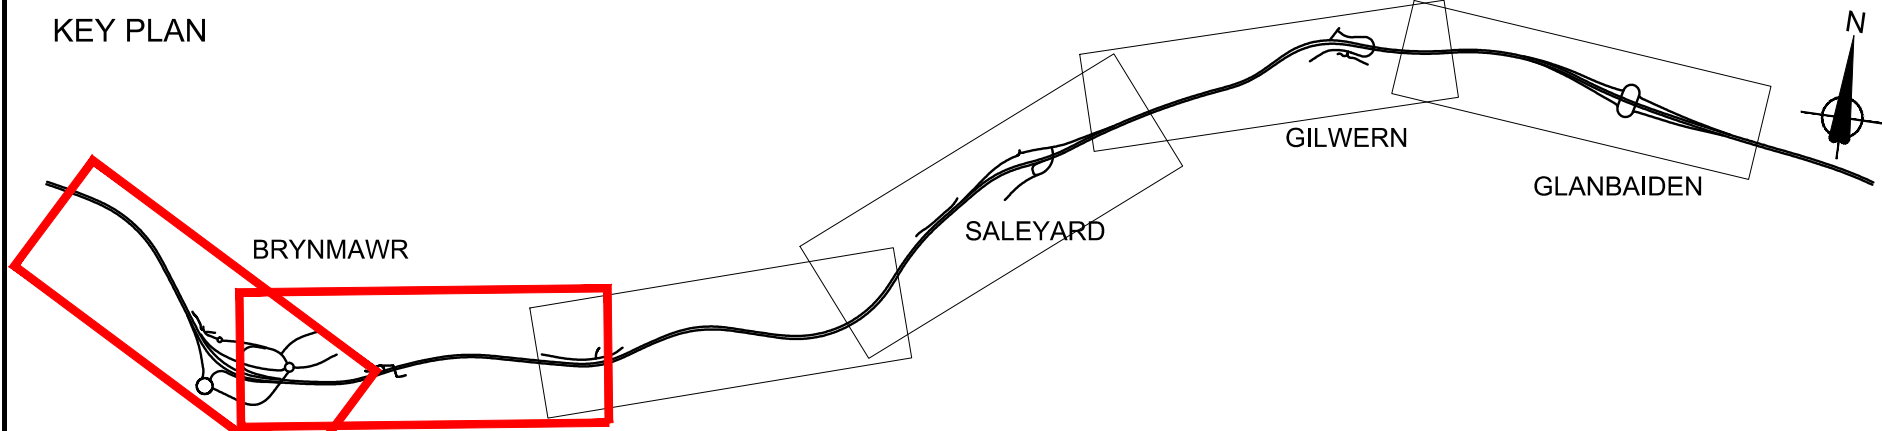


Mark up	Amended extent of 50mph	WW	07/06/21						
P01	For information	LG	23/05/19	HA	SR				
Rev	Description	By	Date	Chk'd	App				




Drawing Title	PERMANENT TRAFFIC RESTRICTIONS IMPOSITION OF 50MPH SPEED LIMIT SHEET 1 OF 3				
Scale	1:2500	Designed / Drawn	Checked	Approved	Authorised
		LG	HA	SR	PS
Original Size	A1	Date	Date	Date	Date
		22/05/19	22/05/19	22/05/19	23/05/19
Drawing number	A465HOV2-CH2-HAC-01_ML-DR-D-0001				Revision
					Mark up

100
10
0
DO NOT SCALE
Millimetres

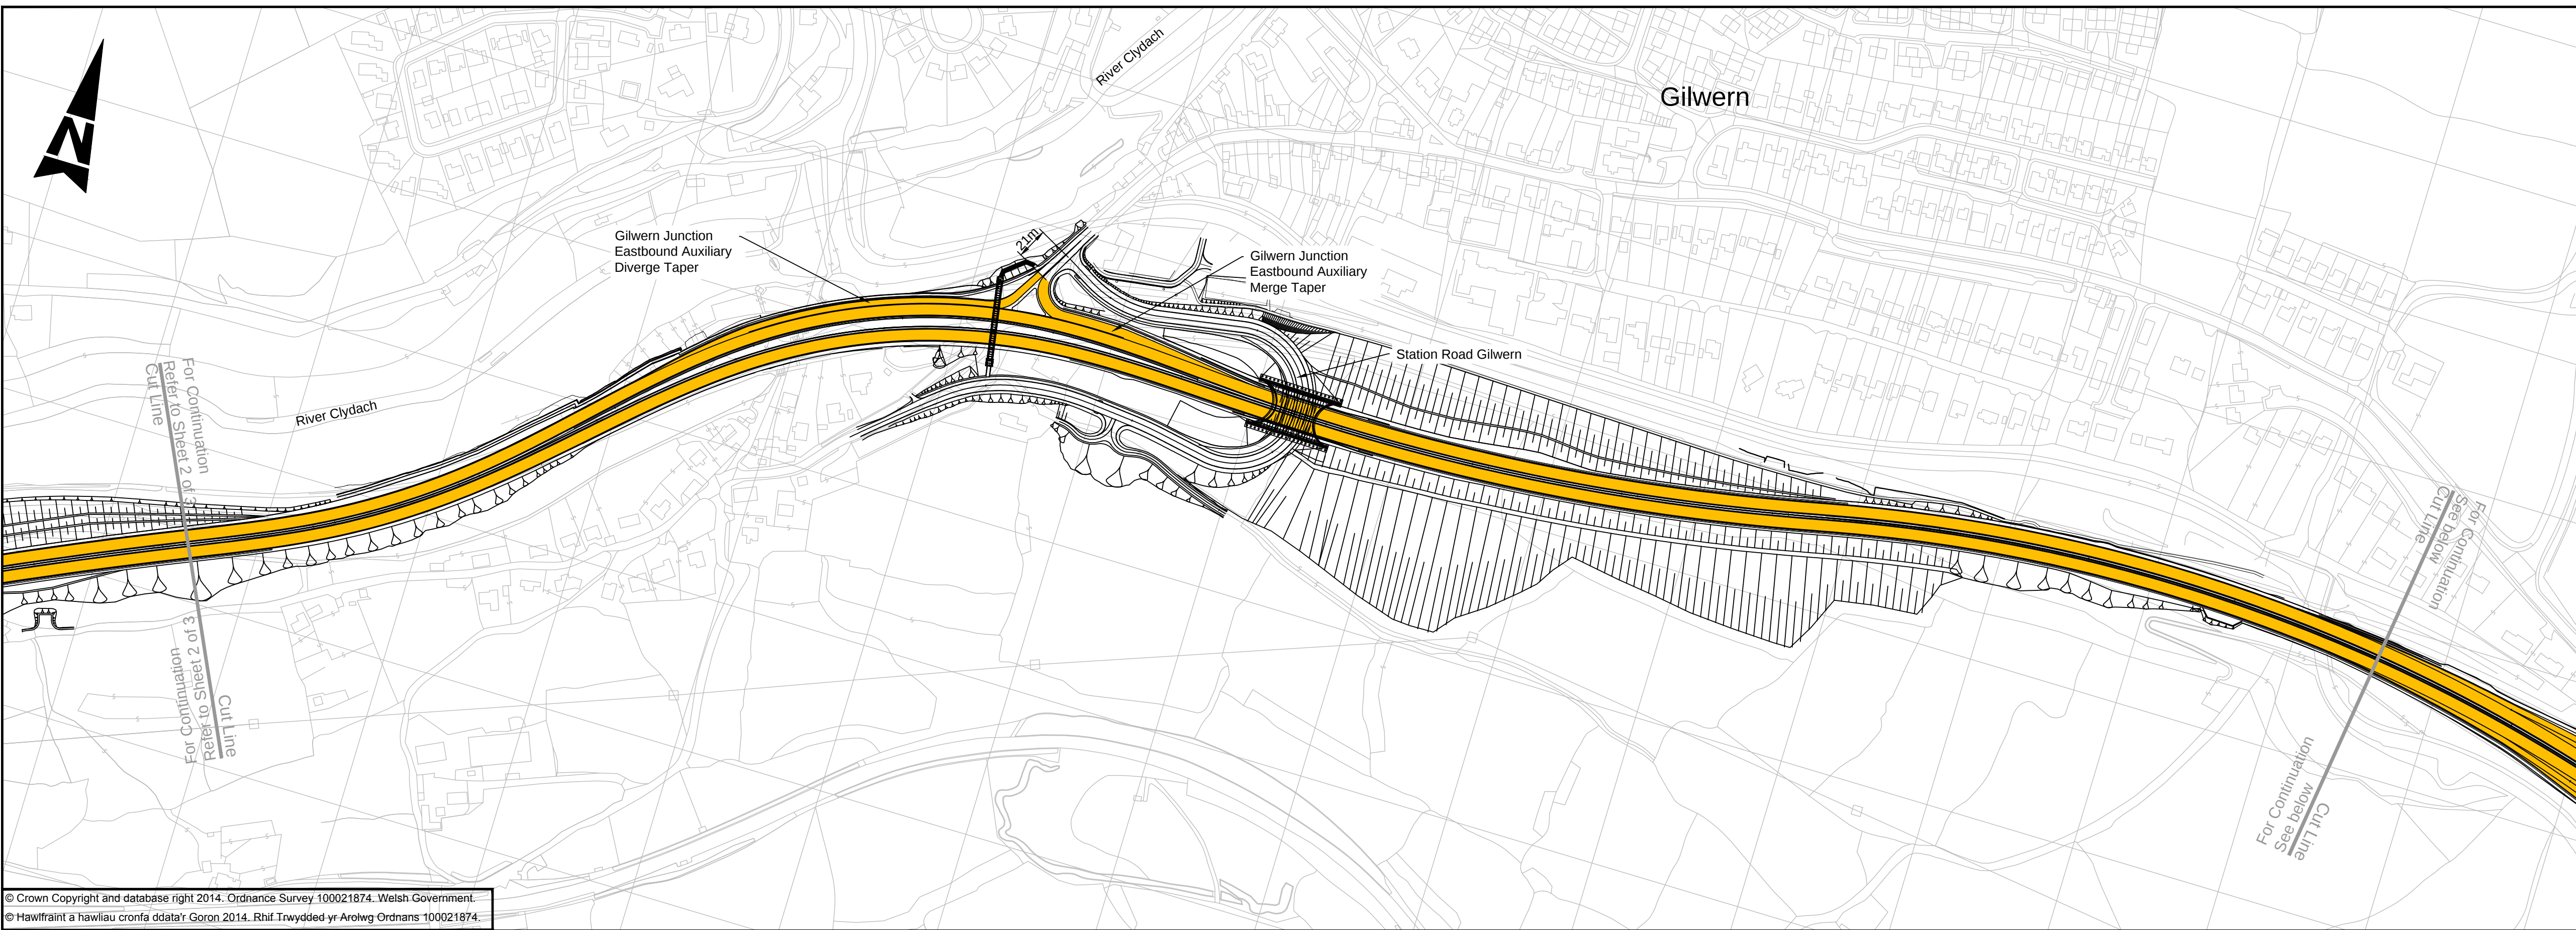


© Crown Copyright and database right 2014. Ordnance Survey 100021874. Welsh Government.
© Hawlfraint a hawliau cronfa ddata'r Goron 2014. Rhif Trwydded yr Arolwg Ordnans 100021874.


PLAN
Scale 1:2500

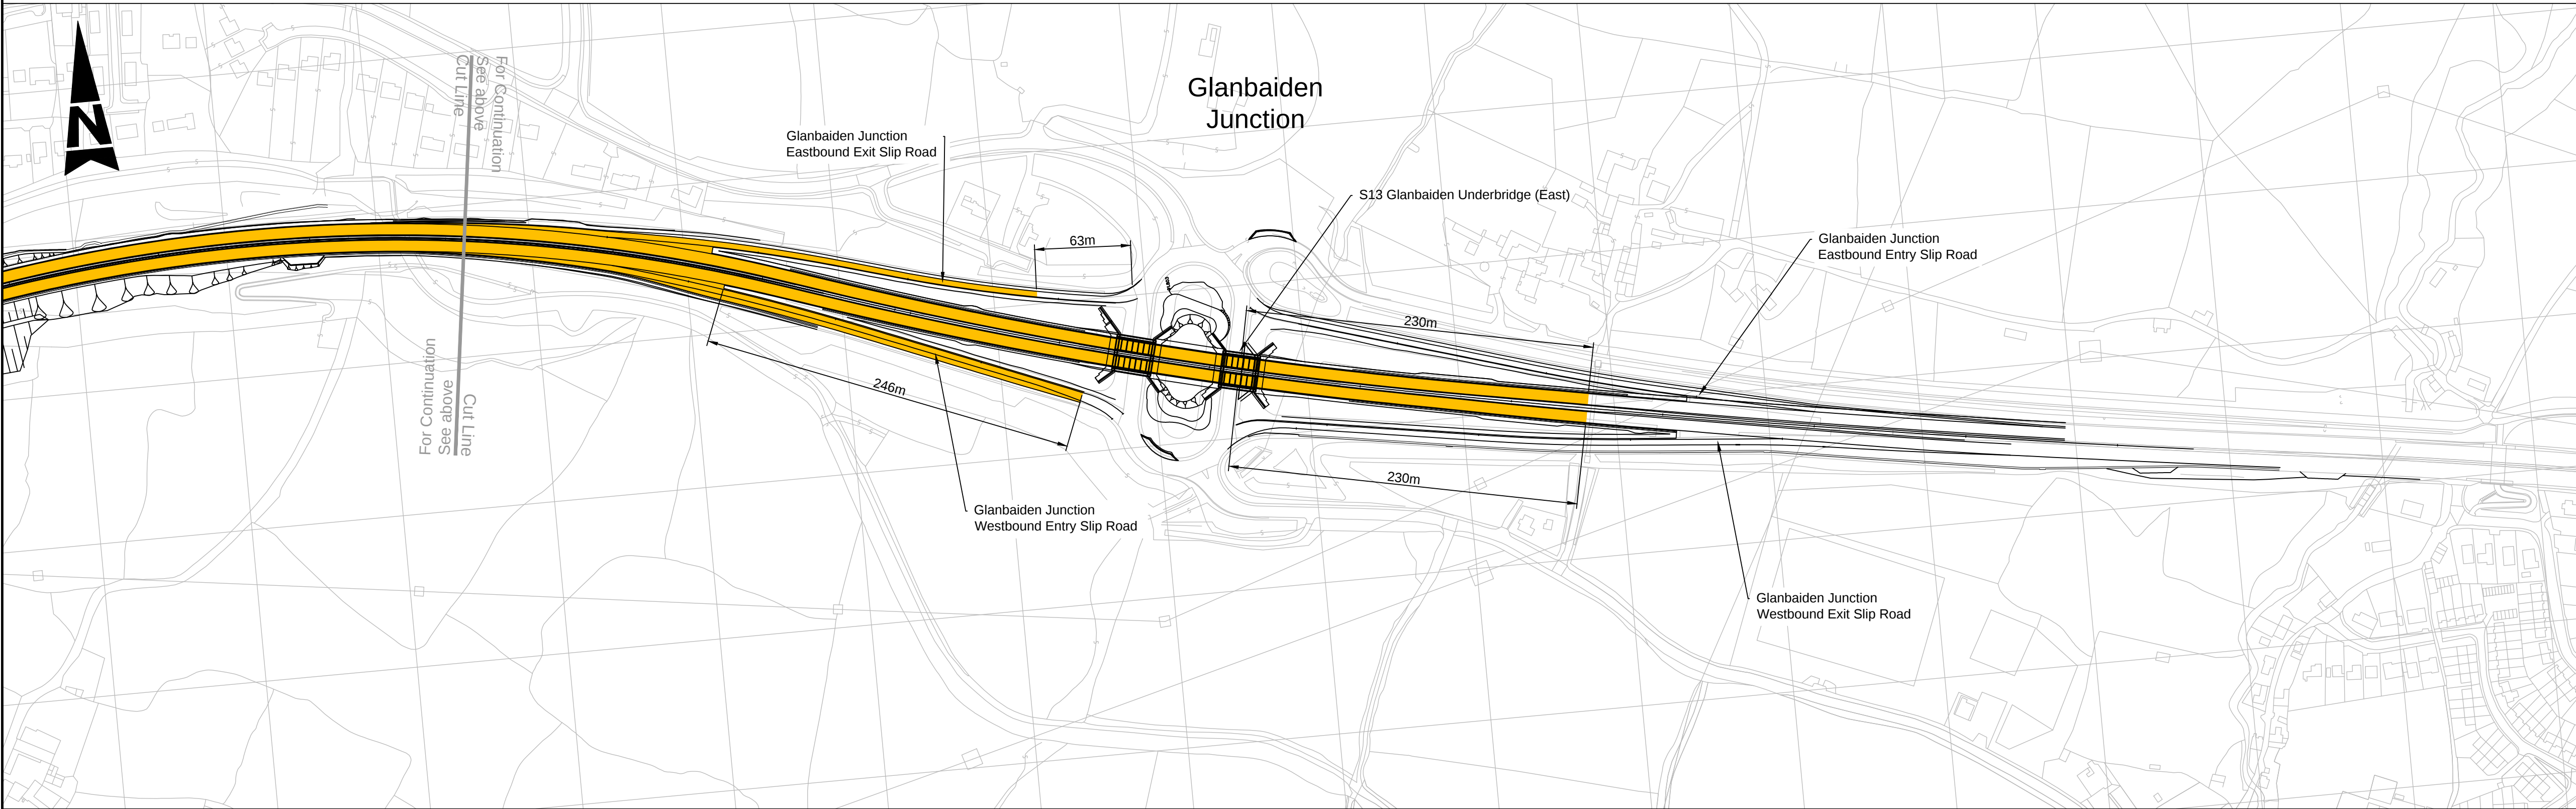

PLAN
Scale 1:2500

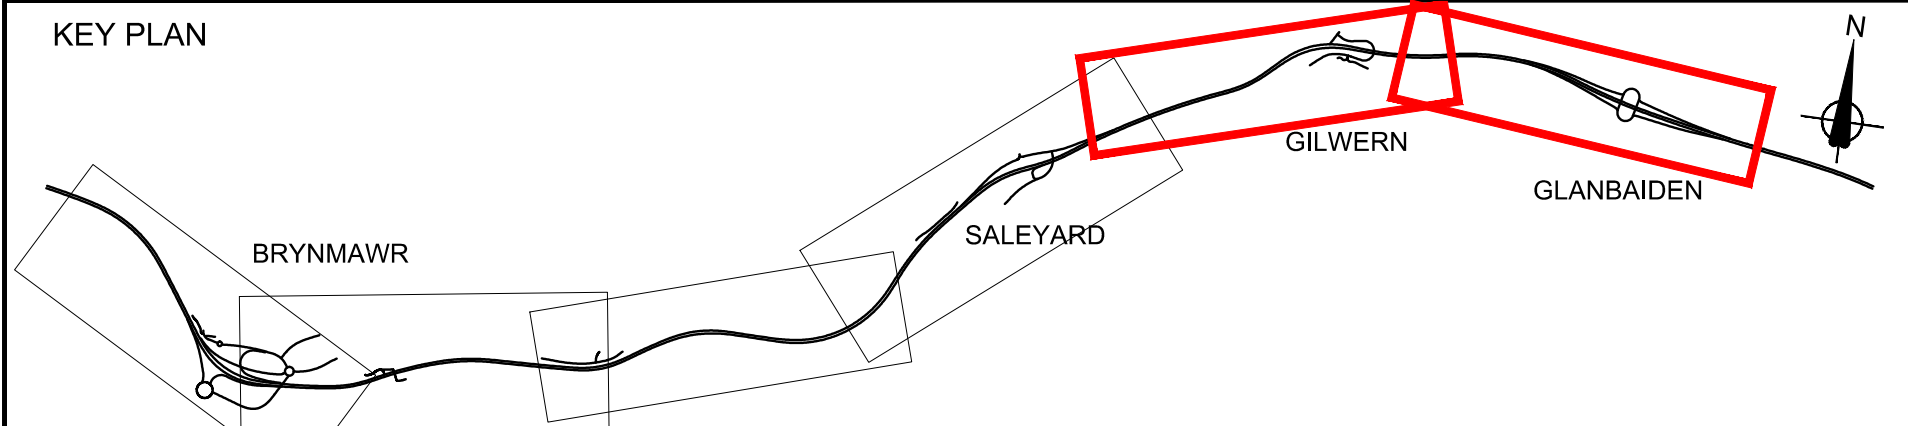

P01	For information	LG	23/05/19	HA	SR
Rev	Description	By	Date	Chk'd	App

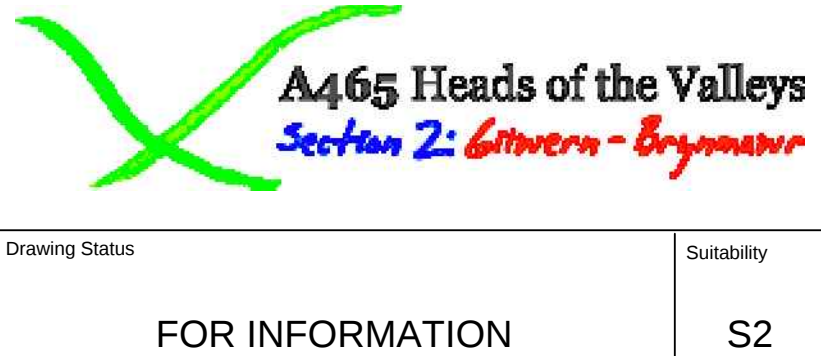

NOTES:
1. To be read in conjunction with Document No. A465HOV2-CH2-HAC-01_ML-DO-D-0025.

LEGEND:

50 mph speed limit extents

Drawing Title PERMANENT TRAFFIC RESTRICTIONS IMPOSITION OF 50MPH SPEED LIMIT SHEET 3 OF 3					
Scale 1:2500	Designed / Drawn LG	Checked HA	Approved SR	Authorised PS	
Original Size A1	Date 22/05/19	Date 22/05/19	Date 22/05/19	Date 23/05/19	
Drawing number A465HOV2-CH2-HAC-01_ML-DR-D-0003					Revision P01