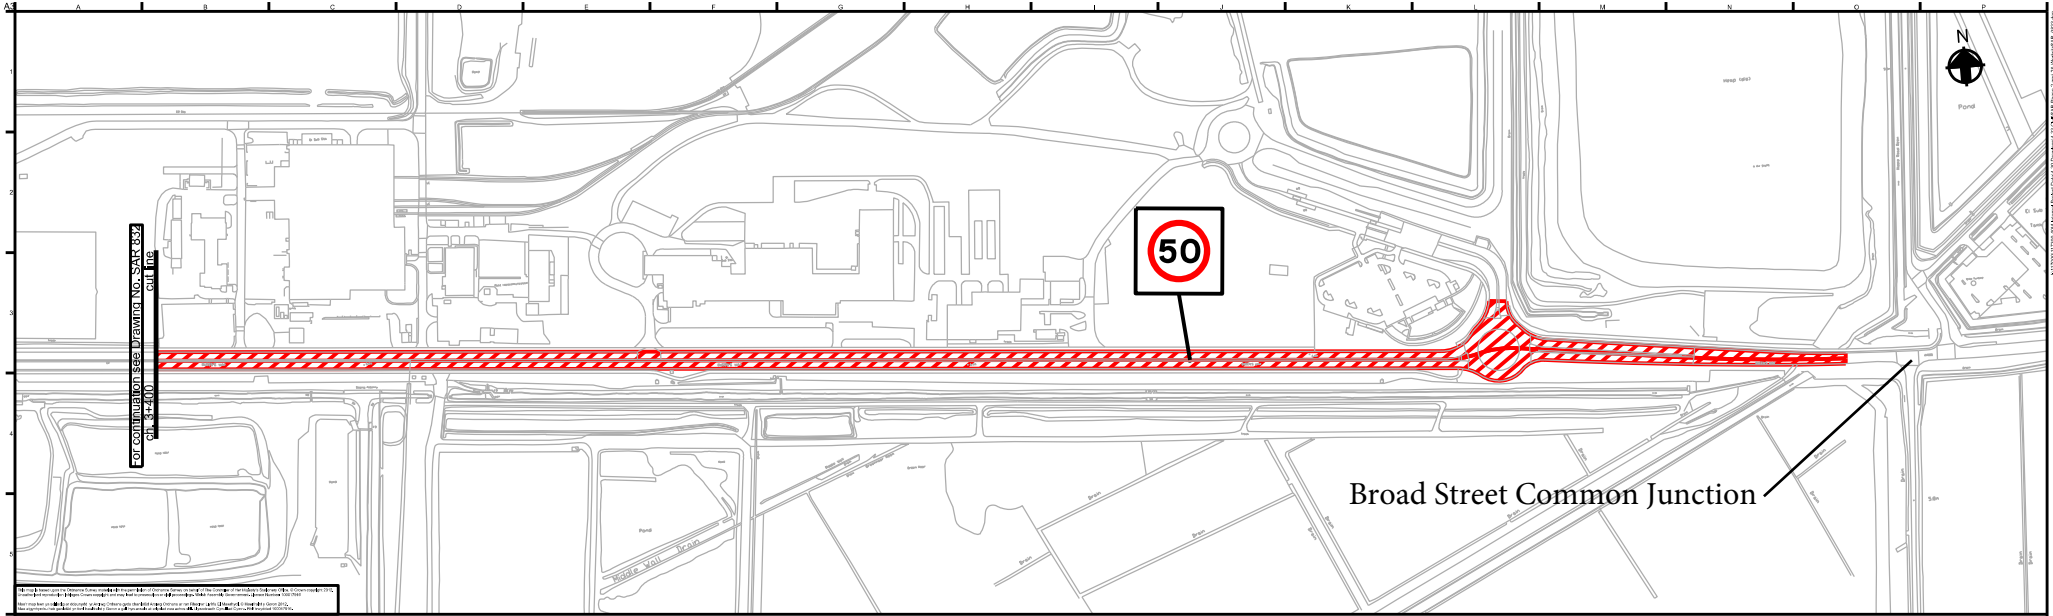

This map is based upon the Ordnance Survey mapping with the permission of Ordnance Survey on behalf of the Controller of Her Majesty's Stationery Office. © Crown copyright. Unauthorised reproduction infringes Crown copyright and may lead to prosecution or civil proceedings. Welsh Assembly Government licence Number 100021593.
Most maps have undergone generalisation in scale and detail and may contain errors or omissions. Land Registry Crown 2012.
Reproduced from Ordnance Survey Landline data with the permission of the Controller of Her Majesty's Stationery Office. © Crown copyright. Unauthorised reproduction infringes Crown copyright and may lead to prosecution or civil proceedings. Welsh Assembly Government licence Number 100021593.

ARUP

4 Richmond St, Capital Waterside
Cardiff, CF10 4QP
T +44(0)29 2047 2327 F +44(0)29 2047 2277

Key:-

- 30mph Speed Limit
- 40mph Speed Limit
- 50mph Speed Limit

X1	04/03/26	AK	AJ	AJ
	TR Amended			
X0	18/07/24	AK	AJ	AJ
	Speed Limit Extents Updated			
A0	21/05/13	LP	RS	RS
	Issued for Approval			
Issue	Date	By	Chkd	Appd

Client:

Llywodraeth Cymru
Welsh Government

Transport
Department of Economy, Science and Transport
Welsh Government
Cathays Park
Cardiff
CF10 3NQ

Trafnidiaeth
Adran yr Economi, Gwyddoniaeth a Thrafnidiaeth
Llywodraeth Cymru
Parc Cathays
Caerdydd
CF10 3NQ

Job Title

M4 Magor to Castleton
Corridor Enhancement Measures
M4 Magwyr i Gas-bach
Mesurau Gwellhau'r Corridor

Drawing Title

Steelworks Access Road
Speed Limit Order
Sheet 3 of 3

Scale at A3: 1:2500

Text:

Drawing Status: As Built

Job No	Drawing No	Issue
117300-40	SAR_0833	X1

© ARUP